


LEFT ELEVATION

3/16"=1'0"




FRONT ELEVATION

1/4"=1'0"

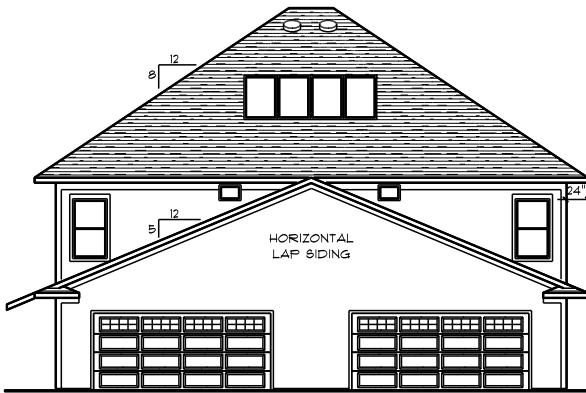

REAR ELEVATION

3/16"=1'0"

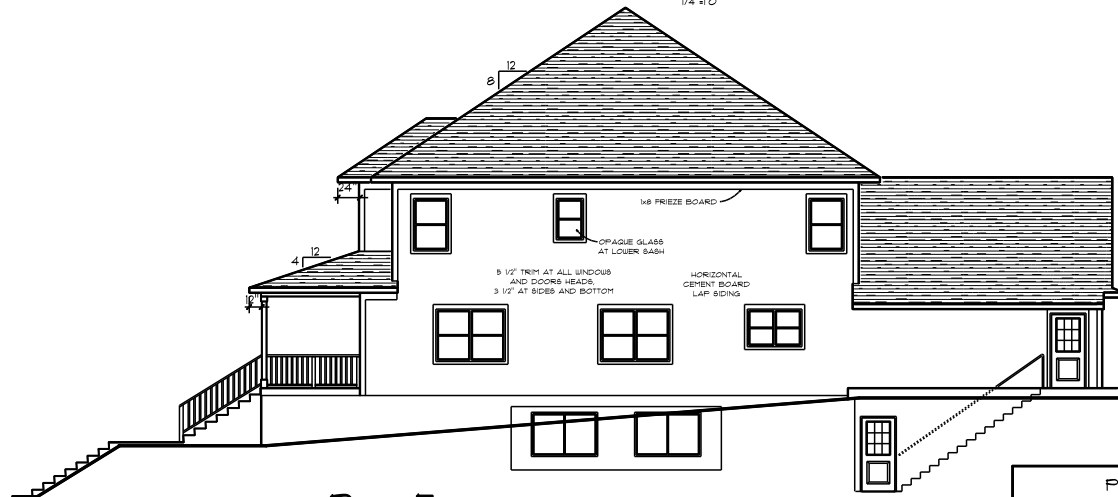

RIGHT ELEVATION

3/16"=1'0"

PARSONS PROPERTIES			
DATE	NOTED	DATE	BY
12-10-08		8-12-08	
1129 & 1129 1/2 EAST WASHINGTON STREET, IOWA CITY			
REVISED "AS-BUILT" DRAWINGS 1-1-10			1 OF 4